

Date: Thursday, 17/08/2006 3:29:43 PM  
User: Linda Lacelle

# Process Sheet

<b>Customer</b> : CU-DAR001 Dart Helicopters Services	<b>Drawing Name</b> : TUBE ASSEMBLY 6"
<b>Job Number</b> : 28230	
<b>Estimate Number</b> : 11194	
<b>P.O. Number</b> : N/A	<b>Part Number</b> : D3298009
<b>This Issue</b> : 17/08/2006 <b>S.O. No.</b> : N/A	<b>Drawing Number</b> : D3298 REV A2
<b>Prsht Rev.</b> : NC	<b>Project Number</b> : N/A
<b>First Issue</b> : N/A <b>Type</b> : SMALL /MED FAB	<b>Drawing Revision</b> : A2
<b>Previous Run</b> : 27567	<b>Material</b> : N/A
<b>Written By</b> : _____	<b>Due Date</b> : 05/09/2006 <b>Qty:</b> 8 <b>Um:</b> Each
<b>Checked &amp; Approved By</b> : _____	
<b>Comment</b> : Est A 04.09.08 New issue KJ/JLM	

Additional Product

Job Number:



<b>Seq. #:</b>	<b>Machine Or Operation:</b>	<b>Description :</b>
----------------	------------------------------	----------------------

1.0	M6061T6T0375W035	6061-T6 Tube .375 x.035W
-----	------------------	--------------------------



**Comment:** Qty.: 0.5250 f(s)/Unit Total : 4.2000 f(s)  
Cut tube to length as per Dwg D3298  
Material: 6061-T6 (WW-T-700/6) tubing Ø0.375" x 0.035" wall (M6061T6T0.375W.035)  
Identify as D3298-009  
Batch: 1117931

FF 06.08.21 8

2.0	MS208196D	Sleeve
-----	-----------	--------



**Comment:** Qty.: 1.0000 Each(s)/Unit Total : 8.0000 Each(s)  
Sleeve  
Pick:  
Qty Part Number Description Batch  
1 MS20819-6D Sleeve 1117654

FF 06.08.21 8

3.0	AN8186D	Nut
-----	---------	-----



**Comment:** Qty.: 1.0000 Each(s)/Unit Total : 8.0000 Each(s)  
Coupling Nut  
Pick:  
Qty Part Number Description Batch  
1 AN818-6D Nut 1117492

FF 06.08.21 8

W/O:		WORK ORDER CHANGES					
DATE	STEP	PROCEDURE CHANGE	By	Date	Qty	Approval Chief Eng / Prod Mgr	Approval QC Inspector

Part No: \_\_\_\_\_ PAR #: \_\_\_\_\_ Fault Category: \_\_\_\_\_ NCR: Yes ☒ No ☐ DQA: ☒ ☐ Date: 06/08/28  
 QA: N/C Closed: \_\_\_\_\_ Date: \_\_\_\_\_

NCR:		WORK ORDER NON-CONFORMANCE (NCR)						
DATE	STEP	Description of NC Section A	Corrective Action Section B			Verification Section C	Approval Chief Eng	Approval QC Inspector
			Initial Chief Eng	Action Description Chief Eng	Sign & Date			

NOTE: Date & initial all entries

Date: Thursday, 17/08/2006 3:29:43 PM  
User: Linda Lacelle

## Process Sheet

Customer: CU-DAR001 Dart Helicopters Services

Drawing Name: TUBE ASSEMBLY 6"

Job Number: 28230

Part Number: D3298009

Job Number:



Seq. #:

Machine Or Operation:

Description :

4.0

SMALL FAB 1

SMALL & MEDIUM FAB RESOURCE 1



Comment: SMALL & MEDIUM FAB RESOURCE 1

Flare end as per Dwg D3298.

Ensure that sleeves and coupling are installed first

FF 06.08.25

8

5.0

QC5

INSPECT WORK TO CURRENT STEP



Comment: INSPECT WORK TO CURRENT STEP

26.08.28 (8)

6.0

PACKAGING 1

PACKAGING RESOURCE #1



Comment: PACKAGING RESOURCE #1

Identify with P/N and B/N using a permanent fine point marker, then Stock

Location: ST420

SL 06/08/28 (8)

7.0

DC

DOCUMENT CONTROL



Comment: DOCUMENT CONTROL

Inspection Level 21

06/08/28 (8)

Job Completion



C 26/08/28

**Dart Aerospace Ltd**

W/O:		WORK ORDER CHANGES					
DATE	STEP	PROCEDURE CHANGE	By	Date	Qty	Approval Chief Eng / Prod Mgr	Approval QC Inspector

Part No: \_\_\_\_\_ PAR #: \_\_\_\_\_ Fault Category: \_\_\_\_\_ NCR: Yes No DQA: \_\_\_\_\_ Date: \_\_\_\_\_

QA: N/C Closed: \_\_\_\_\_ Date: \_\_\_\_\_

NCR:		WORK ORDER NON-CONFORMANCE (NCR)						
DATE	STEP	Description of NC Section A	Corrective Action Section B			Verification Section C	Approval Chief Eng	Approval QC Inspector
			Initial Chief Eng	Action Description Chief Eng	Sign & Date			

**NOTE:** Date & initial all entries



DESIGN <i>[Signature]</i>	DRAWN BY <i>[Signature]</i>	<b>DART AEROSPACE LTD</b> HAWKESBURY, ONTARIO, CANADA	
CHECKED <i>[Signature]</i>	APPROVED <i>[Signature]</i>	DRAWING NO. D3298	REV. A SHEET 1 OF 7
DATE 04.07.06		TITLE TUBE ASSEMBLIES	SCALE NTS
A	04.07.06	NEW ISSUE	
A1	<del>04.11.30</del>	CORRECT VIEW D3298-003; 16.50 WAS 15.75	
A2	<del>05.05.06</del>	FOR D3298-001/-003 16.00 WAS 16.50	

RELEASED  
04.07.09 *[Signature]*

P/N	TEMPLATE	CUT LENGTH OF TUBE	MS20819-6D SLEEVE	AN818-6D NUT	DESC.	MATERIAL
D3298-001	D3298-001T1	25.00	2	2	TUBE ASS'Y	6061-T6 0.375 OD x 0.035 W (WW-T-700/6)
D3298-003	D3298-003T1	27.00	2	2	TUBE ASS'Y	6061-T6 0.375 OD x 0.035 W (WW-T-700/6)
D3298-005	D3298-005T1	23.00	2	2	TUBE ASS'Y	6061-T6 0.375 OD x 0.035 W (WW-T-700/6)
D3298-007	D3298-007T1	8.00	2	2	TUBE ASS'Y	6061-T6 0.375 OD x 0.035 W (WW-T-700/6)
D3298-009	D3298-009T1	6.00	1	1	TUBE ASS'Y	6061-T6 0.375 OD x 0.035 W (WW-T-700/6)
D3298-011	D3298-011T1	8.00	2	2	TUBE ASS'Y	6061-T6 0.375 OD x 0.035 W (WW-T-700/6)
D3298-013	D3298-013T1	10.00	2	2	TUBE ASS'Y	6061-T6 0.375 OD x 0.035 W (WW-T-700/6)
D3298-015	D3298-015T1	14.00	1	1	TUBE ASS'Y	6061-T6 0.375 OD x 0.035 W (WW-T-700/6)

**Notes:**

- (1) TUBING ASSEMBLIES TO BE CUT AND BENT IN ACCORDANCE WITH TEMPLATES.
- (2) TUBES TO BE FLARED 37° TO MATE WITH FITTINGS MADE TO MS33514.
- (3) ENSURE SEAMLESS TUBING IS USED.
- (4) 5052 (WW-T-700/4) TUBING MAY BE SUBSTITUTED WHEN 6061 TUBING IS NOT AVAILABLE.
- (5) TOLERANCES ARE PER DART QSI 018 UNLESS OTHERWISE NOTED.
- (6) ALL DIMENSIONS ARE IN INCHES
- (7) IDENTIFY WITH DART P/N & B/N USING FINE POINT PERMANENT MARKER


Copyright © 2004 by DART AEROSPACE LTD

THIS DOCUMENT IS PRIVATE AND CONFIDENTIAL AND IS SUPPLIED ON THE EXPRESS CONDITION THAT IT IS NOT TO BE USED FOR ANY PURPOSE OR COPIED OR COMMUNICATED TO ANY OTHER PERSON WITHOUT WRITTEN PERMISSION FROM DART AEROSPACE LTD.



DESIGN #	DRAWN BY #	DART AEROSPACE LTD HAWKESBURY, ONTARIO, CANADA	
CHECKED #	APPROVED #	DRAWING NO. D3298	REV. A SHEET 2 OF 7
DATE 04.07.06		TITLE TUBE ASSEMBLIES	SCALE NTS

RELEASED  
04.09.09 #

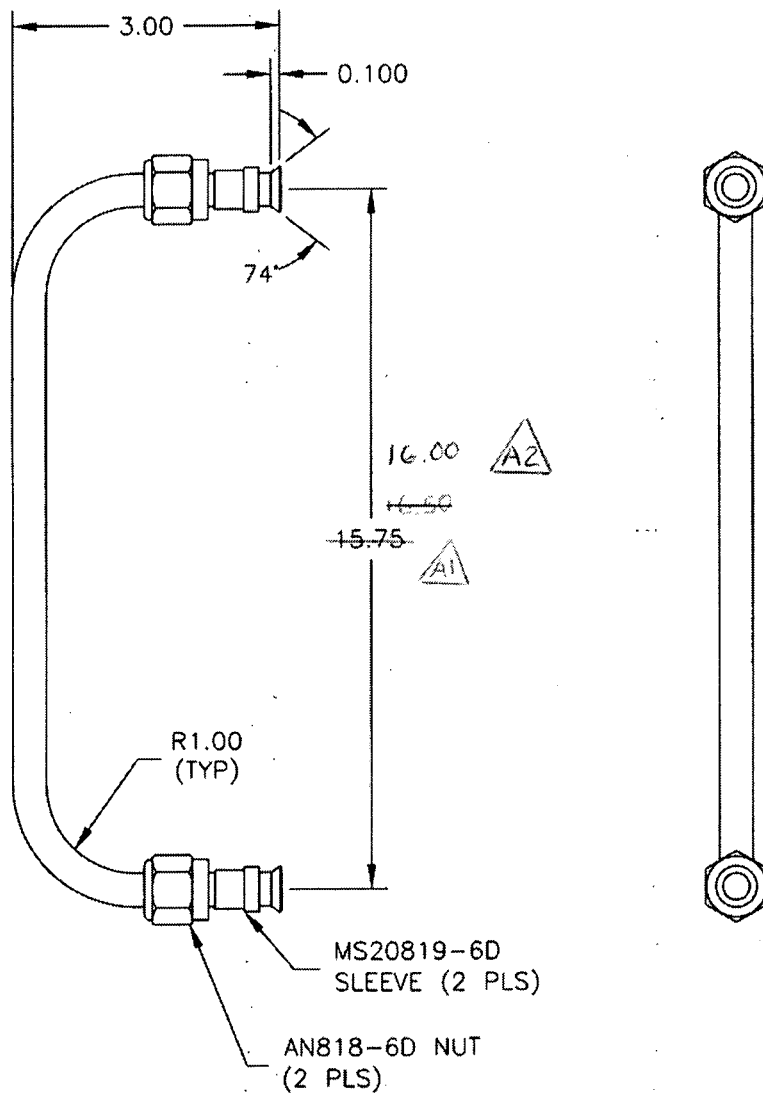

**D3298-001**


Copyright © 2004 by DART AEROSPACE LTD

THIS DOCUMENT IS PRIVATE AND CONFIDENTIAL AND IS SUPPLIED ON THE EXPRESS CONDITION THAT IT IS NOT TO BE USED FOR ANY PURPOSE OR COPIED OR COMMUNICATED TO ANY OTHER PERSON WITHOUT WRITTEN PERMISSION FROM DART AEROSPACE LTD.



DESIGN #	DRAWN BY #	DART AEROSPACE LTD HAWKESBURY, ONTARIO, CANADA	
CHECKED #	APPROVED #	DRAWING NO. D3298	REV. A SHEET 3 OF 7
DATE 04.07.06		TITLE TUBE ASSEMBLIES	SCALE NTS

RELEASED  
04.07.09

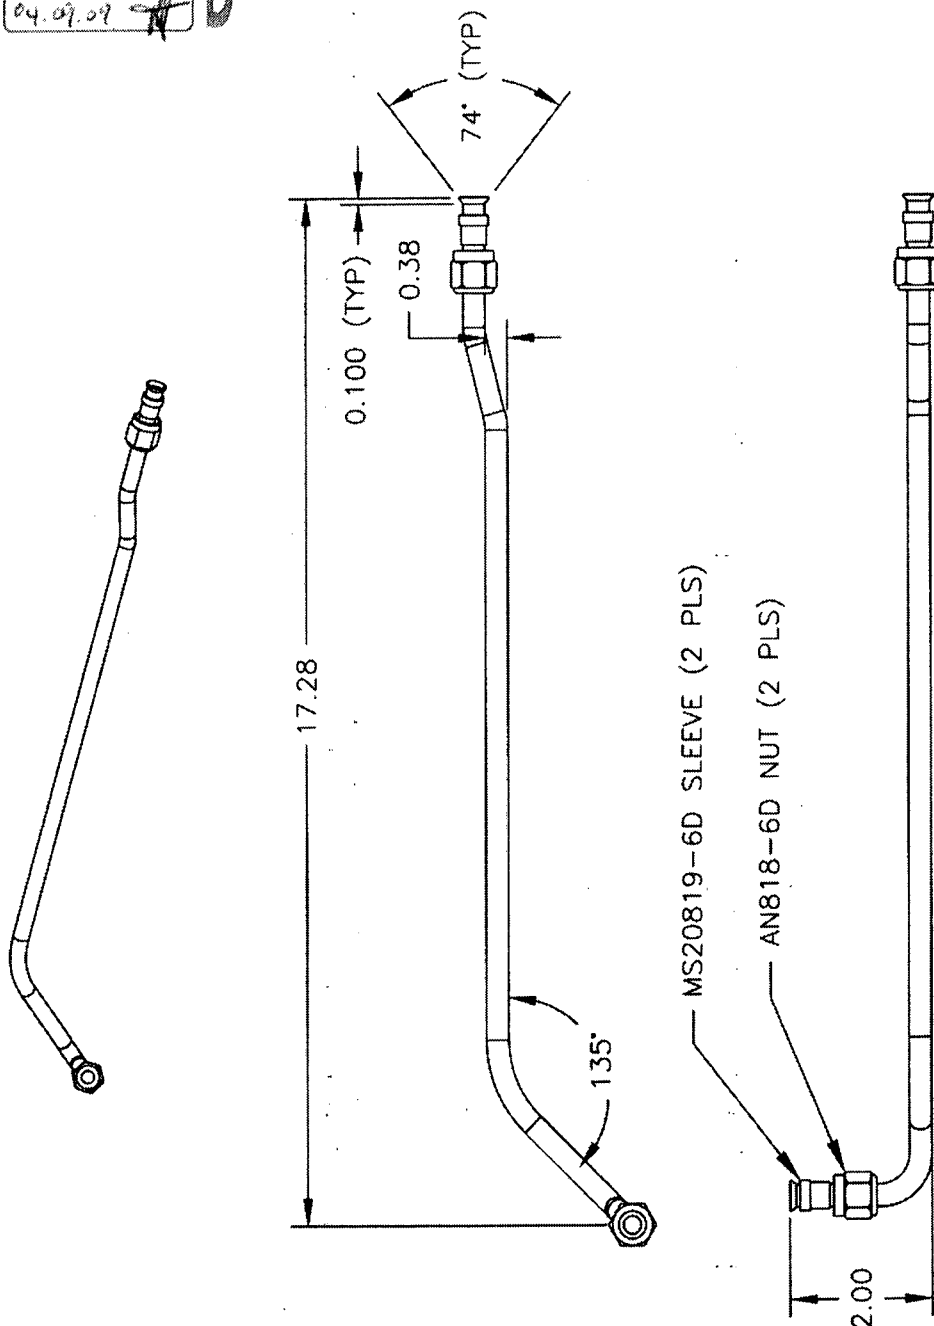

D3298-005


Copyright © 2004 by DART AEROSPACE LTD

THIS DOCUMENT IS PRIVATE AND CONFIDENTIAL AND IS SUPPLIED ON THE EXPRESS CONDITION THAT IT IS NOT TO BE USED FOR ANY PURPOSE OR COPIED OR COMMUNICATED TO ANY OTHER PERSON WITHOUT WRITTEN PERMISSION FROM DART AEROSPACE LTD.




DESIGN RT	DRAWN BY RT	DART AEROSPACE LTD HAWKESBURY, ONTARIO, CANADA	
CHECKED RT	APPROVED RT	DRAWING NO. D3298	REV. A SHEET 4 OF 7
DATE 04.07.06		TITLE TUBE ASSEMBLIES	SCALE NTS

RELEASED  
04.07.07

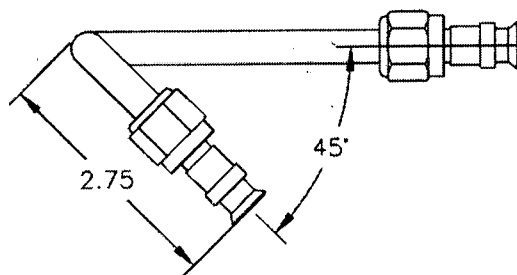

D3298-003

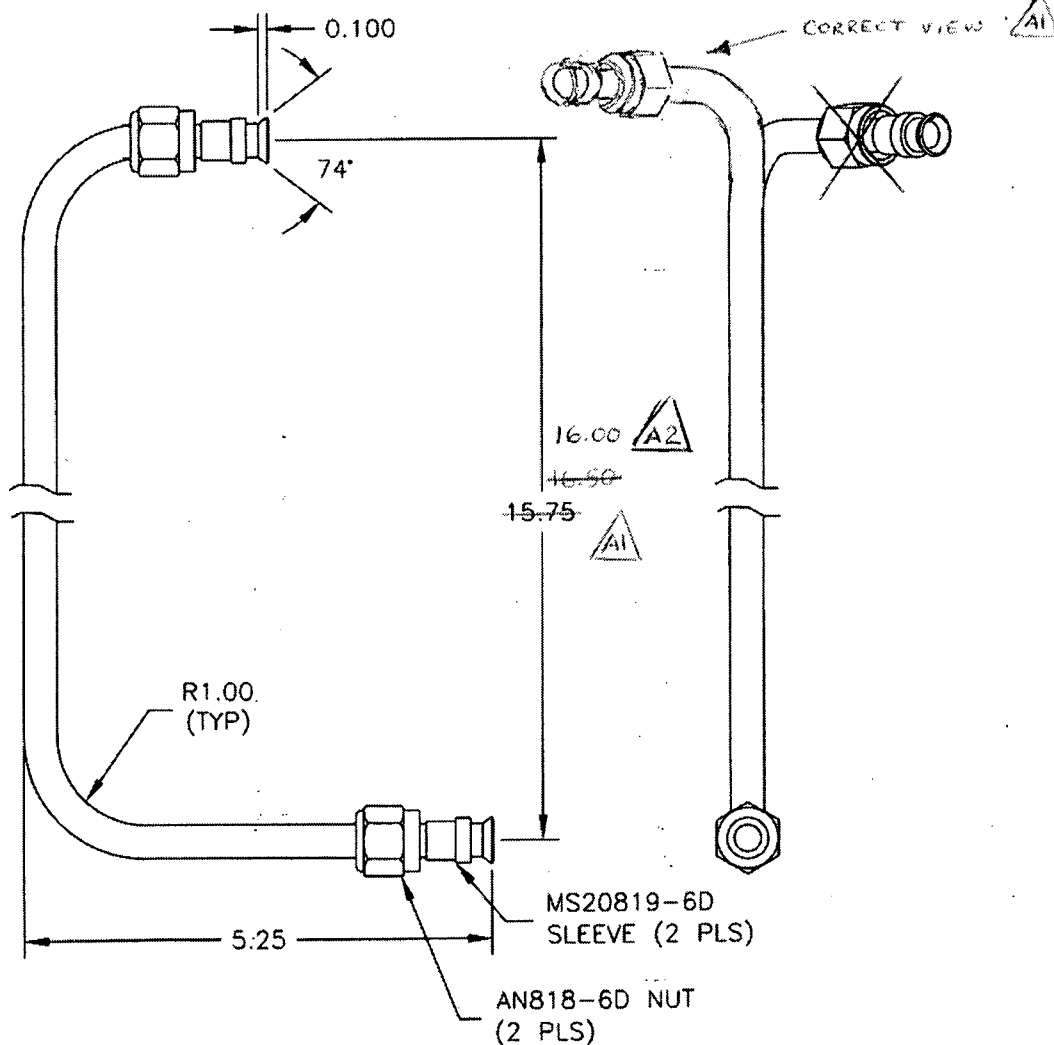





Copyright © 2004 by DART AEROSPACE LTD



THIS DOCUMENT IS PRIVATE AND CONFIDENTIAL AND IS SUPPLIED ON THE EXPRESS CONDITION THAT IT IS NOT TO BE USED FOR ANY PURPOSE OR COPIED OR COMMUNICATED TO ANY OTHER PERSON WITHOUT WRITTEN PERMISSION FROM DART AEROSPACE LTD.




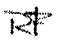


DESIGN 	DRAWN BY 	DART AEROSPACE LTD HAWKESBURY, ONTARIO, CANADA	
CHECKED 	APPROVED 	DRAWING NO. D3298	REV. A SHEET 5 OF 7
DATE 04.07.06		TITLE TUBE ASSEMBLIES	SCALE NTS

RELEASED  
04.09.09 

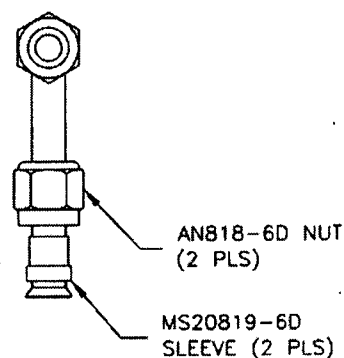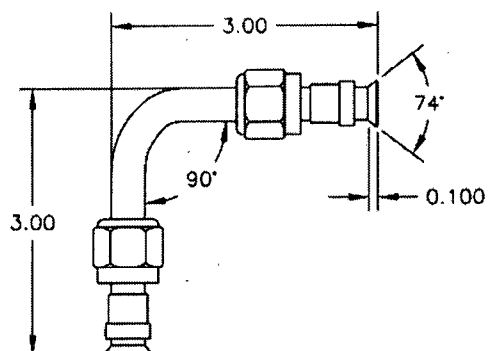

**D3298-007**

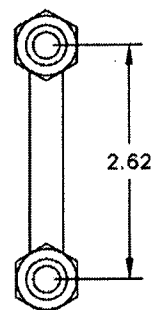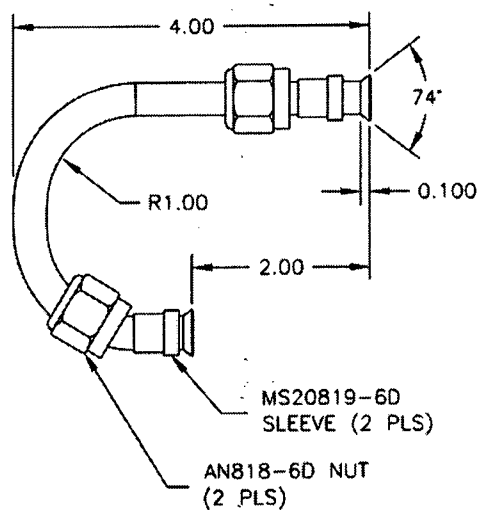

**D3298-013**





Copyright © 2004 by DART AEROSPACE LTD

THIS DOCUMENT IS PRIVATE AND CONFIDENTIAL AND IS SUPPLIED ON THE EXPRESS CONDITION THAT IT IS NOT TO BE USED FOR ANY PURPOSE OR COPIED OR COMMUNICATED TO ANY OTHER PERSON WITHOUT WRITTEN PERMISSION FROM DART AEROSPACE LTD.




DESIGN <i>[Signature]</i>	DRAWN BY <i>[Signature]</i>	DART AEROSPACE LTD HAWKESBURY, ONTARIO, CANADA	
CHECKED <i>[Signature]</i>	APPROVED <i>[Signature]</i>	DRAWING NO. D3298	REV. A SHEET 6 OF 7
DATE 04.07.06		TITLE TUBE ASSEMBLIES	SCALE NTS

RELEASED  
07.07.09

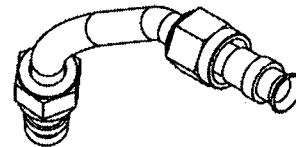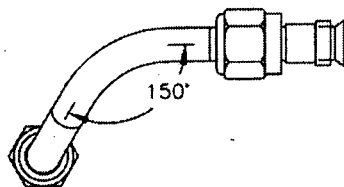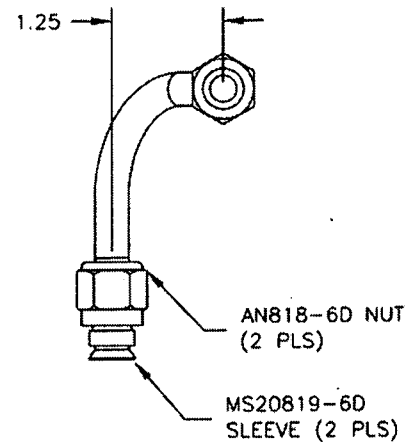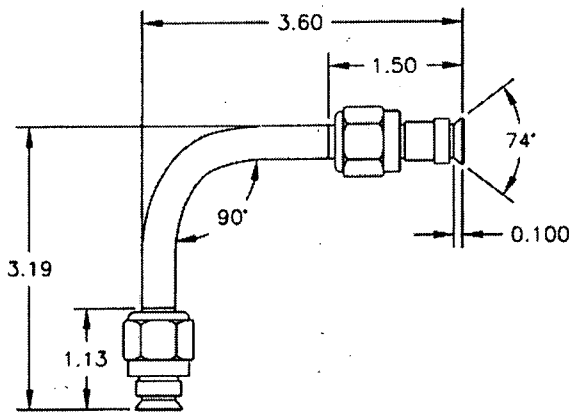

**D3298-011**

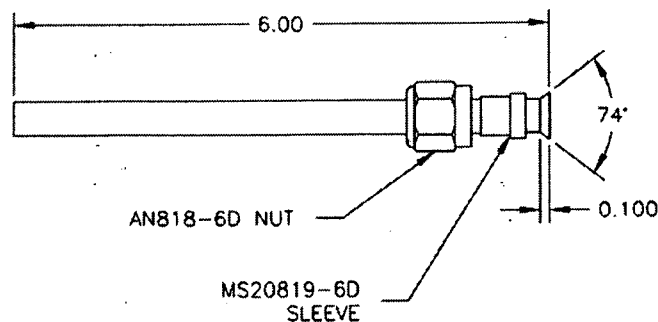

**D3298-009**



Copyright © 2004 by DART AEROSPACE LTD

THIS DOCUMENT IS PRIVATE AND CONFIDENTIAL AND IS SUPPLIED ON THE EXPRESS CONDITION THAT IT IS NOT TO BE USED FOR ANY PURPOSE OR COPIED OR COMMUNICATED TO ANY OTHER PERSON WITHOUT WRITTEN PERMISSION FROM DART AEROSPACE LTD.



DESIGN [Signature]	DRAWN BY [Signature]	DART AEROSPACE LTD HAWKESBURY, ONTARIO, CANADA	
CHECKED [Signature]	APPROVED [Signature]	DRAWING NO. D3298	REV. A SHEET 7 OF 7
DATE 04.07.06		TITLE TUBE ASSEMBLIES	SCALE NTS

RELEASED  
04.07.06

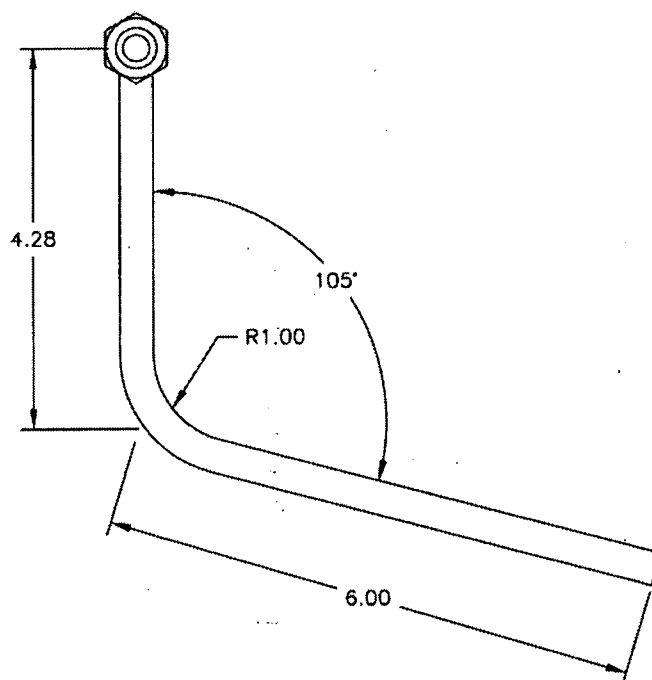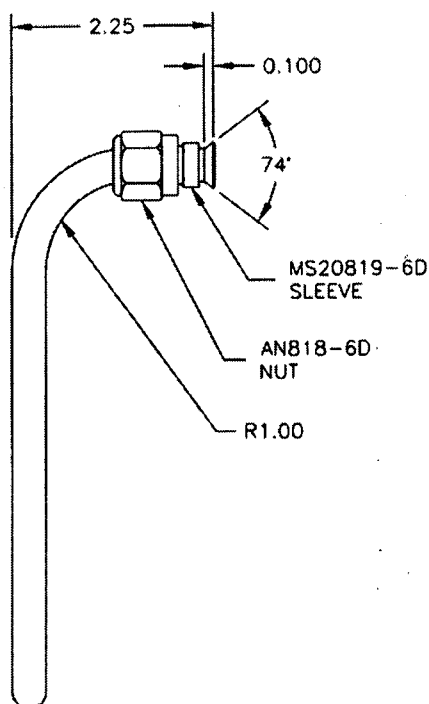

**D3298-015**

Copyright © 2004 by DART AEROSPACE LTD

THIS DOCUMENT IS PRIVATE AND CONFIDENTIAL AND IS SUPPLIED ON THE EXPRESS CONDITION THAT IT IS NOT TO BE USED FOR ANY PURPOSE OR COPIED OR COMMUNICATED TO ANY OTHER PERSON WITHOUT WRITTEN PERMISSION FROM DART AEROSPACE LTD.